




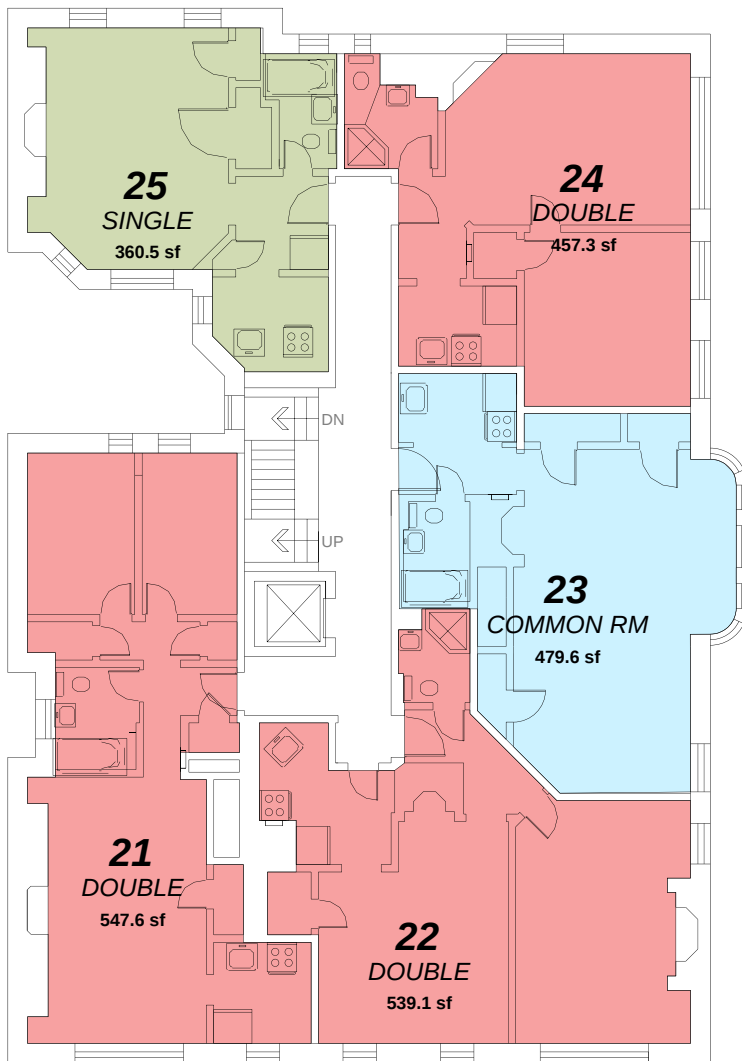

HARVARD UNIVERSITY

FACULTY OF ARTS AND SCIENCES

Office of Physical Resources and Planning

02

General (areas in SF)

|                         | Units      | Actual (SF)    |
|-------------------------|------------|----------------|
| <div>Common Rm</div>    | 1.0        | 479.6          |
| <div>Res_1 Single</div> | 1.0        | 360.5          |
| <div>Res_2 Double</div> | 3.0        | 1,543.9        |
| <b>TOTALS</b>           | <b>5.0</b> | <b>2,384.1</b> |

Ridgely Hall - Swing House

65 Mount Auburn Street, Cambridge MA 02138

Second

As Built

Feb 10, 2022







## RIDGELY HALL

### SECOND FLOOR

BLDG # 06098

DATE: 11/01/2012

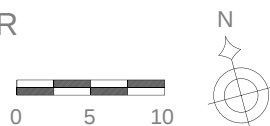

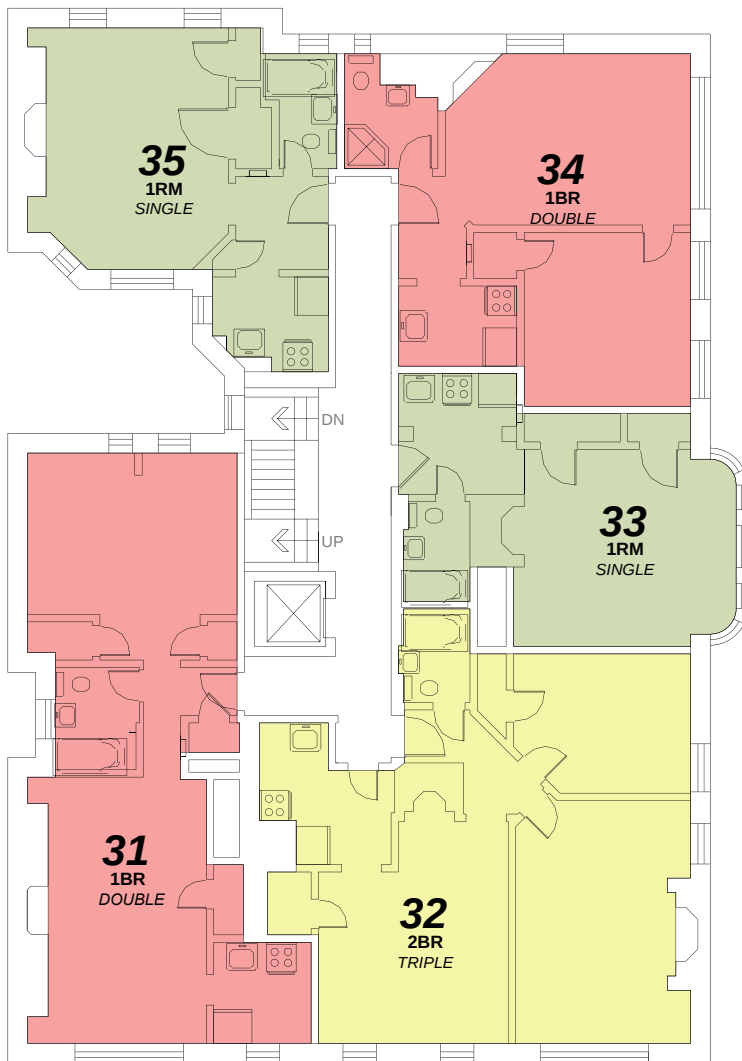

|  <b>HARVARD UNIVERSITY</b><br>FACULTY OF ARTS AND SCIENCES<br>Office of Physical Resources and Planning |              | 03         |                |
|--------------------------------------------------------------------------------------------------------------------------------------------------------------------------------------------|--------------|------------|----------------|
| General (areas in SF)                                                                                                                                                                      |              | Units      | Actual (SF)    |
|                                                                                                         | Res_1 Single | 2.0        | 692.0          |
|                                                                                                         | Res_2 Double | 2.0        | 1,004.8        |
|                                                                                                         | Res_3 Triple | 1.0        | 671.2          |
| <b>TOTALS</b>                                                                                                                                                                              |              | <b>5.0</b> | <b>2,368.0</b> |


|                                                                                                                      |  |
|----------------------------------------------------------------------------------------------------------------------|--|
| <b>Ridgely Hall - Swing House</b><br>65 Mount Auburn Street, Cambridge MA 02138<br>Third<br>As Built<br>Feb 10, 2022 |  |
|                                 |  |
|                                 |  |


## RIDGELY HALL

### THIRD FLOOR

BLDG # 06098

DATE: 11/01/2012

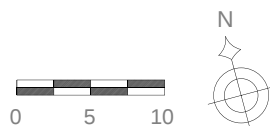

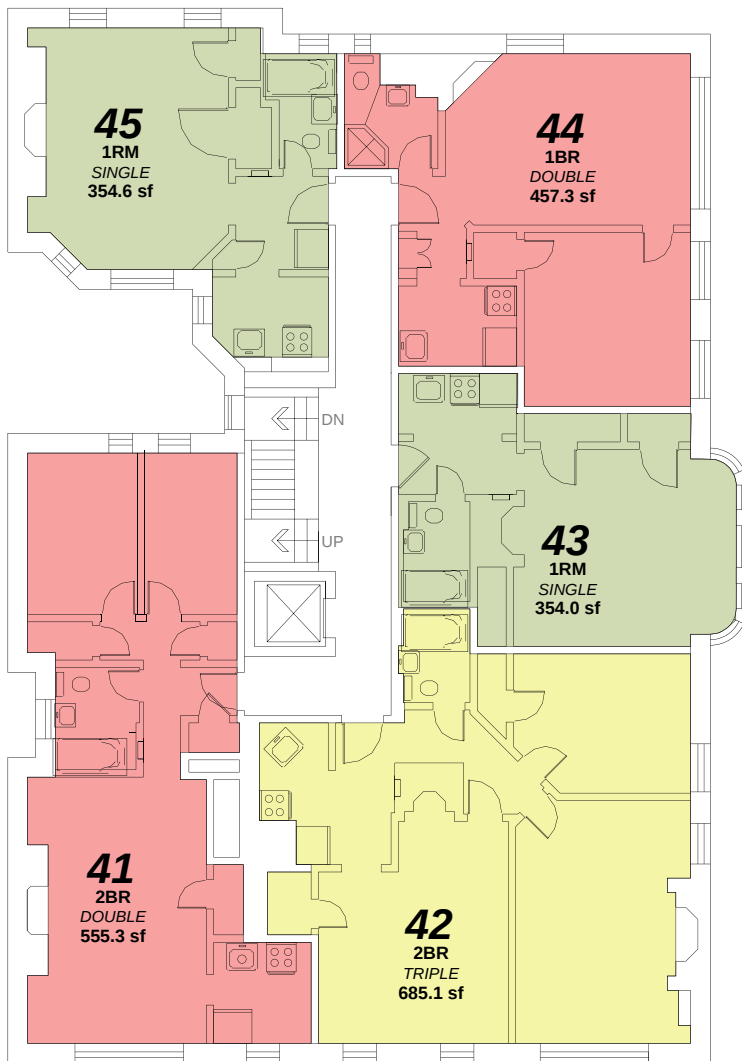

|  <b>HARVARD UNIVERSITY</b><br>FACULTY OF ARTS AND SCIENCES<br>Office of Physical Resources and Planning |              | 04         |                |
|--------------------------------------------------------------------------------------------------------------------------------------------------------------------------------------------|--------------|------------|----------------|
| General (areas in SF)                                                                                                                                                                      |              | Units      | Actual (SF)    |
|                                                                                                         | Res_1 Single | 2.0        | 708.6          |
|                                                                                                         | Res_2 Double | 2.0        | 1,012.5        |
|                                                                                                         | Res_3 Triple | 1.0        | 685.1          |
| <b>TOTALS</b>                                                                                                                                                                              |              | <b>5.0</b> | <b>2,406.2</b> |


|                                                                                                                              |  |
|------------------------------------------------------------------------------------------------------------------------------|--|
| <b>Ridgely Hall - Swing House</b><br>65 Mount Auburn Street, Cambridge MA 02138<br><b>Fourth</b><br>As Built<br>Feb 10, 2022 |  |
|                                         |  |
|                                         |  |


## RIDGELY HALL

### FOURTH FLOOR

BLDG # 06098

DATE: 11/01/2012

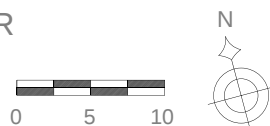

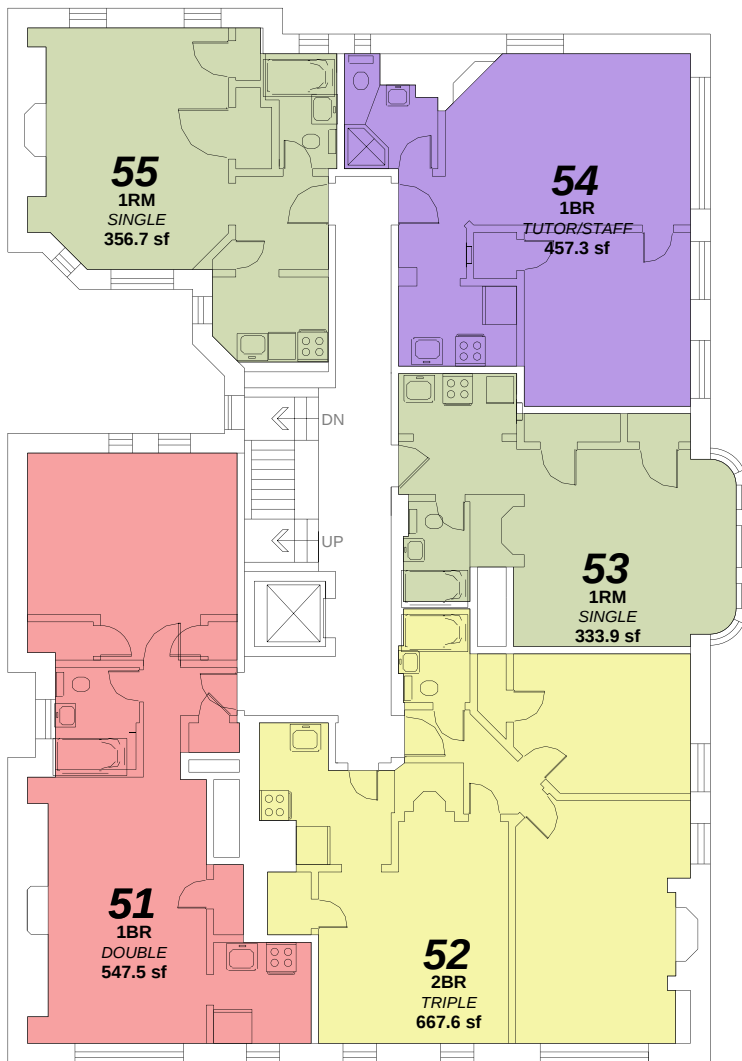

|  <b>HARVARD UNIVERSITY</b><br>FACULTY OF ARTS AND SCIENCES<br>Office of Physical Resources and Planning |                 | 05         |                |
|--------------------------------------------------------------------------------------------------------------------------------------------------------------------------------------------|-----------------|------------|----------------|
| General (areas in SF)                                                                                                                                                                      |                 | Units      | Actual (SF)    |
|                                                                                                         | Res_1 Single    | 2.0        | 690.6          |
|                                                                                                         | Res_2 Double    | 1.0        | 547.5          |
|                                                                                                         | Res_3 Triple    | 1.0        | 667.6          |
|                                                                                                         | Res_Tutor/Staff | 1.0        | 457.3          |
| <b>TOTALS</b>                                                                                                                                                                              |                 | <b>5.0</b> | <b>2,363.0</b> |

|                                            |  |
|--------------------------------------------|--|
| <b>Ridgely Hall - Swing House</b>          |  |
| 65 Mount Auburn Street, Cambridge MA 02138 |  |
| Fifth                                      |  |
| As Built                                   |  |
| Feb 10, 2022                               |  |


  



# RIDGELY HALL

## FIFTH FLOOR

BLDG # 06098

DATE: 11/01/2012

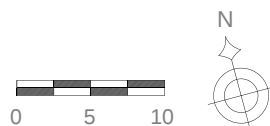

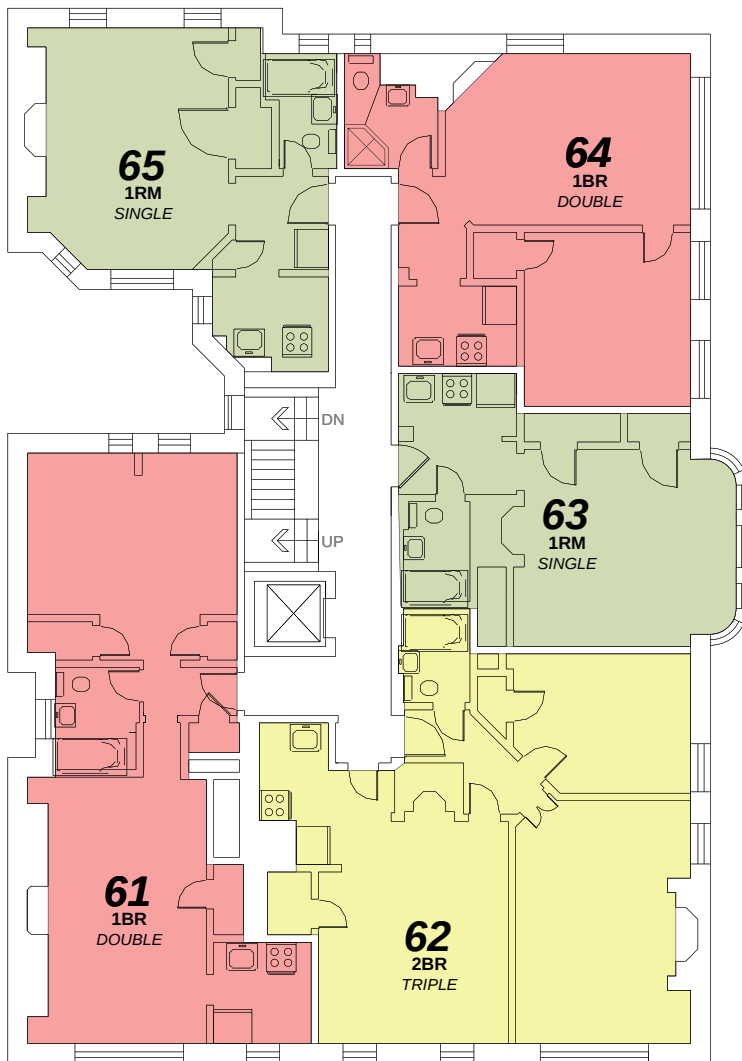

|  <b>HARVARD UNIVERSITY</b><br>FACULTY OF ARTS AND SCIENCES<br>Office of Physical Resources and Planning |              | 06         |                |
|--------------------------------------------------------------------------------------------------------------------------------------------------------------------------------------------|--------------|------------|----------------|
| General (areas in SF)                                                                                                                                                                      |              | Units      | Actual (SF)    |
|                                                                                                         | Res_1 Single | 2.0        | 711.6          |
|                                                                                                         | Res_2 Double | 2.0        | 1,005.9        |
|                                                                                                         | Res_3 Triple | 1.0        | 671.2          |
| <b>TOTALS</b>                                                                                                                                                                              |              | <b>5.0</b> | <b>2,388.7</b> |

|                                            |  |
|--------------------------------------------|--|
| <b>Ridgely Hall - Swing House</b>          |  |
| 65 Mount Auburn Street, Cambridge MA 02138 |  |
| Sixth                                      |  |
| As Built                                   |  |
| Feb 10, 2022                               |  |


  



## RIDGELY HALL

### SIXTH FLOOR

BLDG # 06098

DATE: 11/01/2012

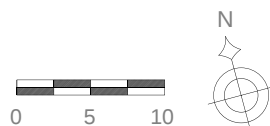

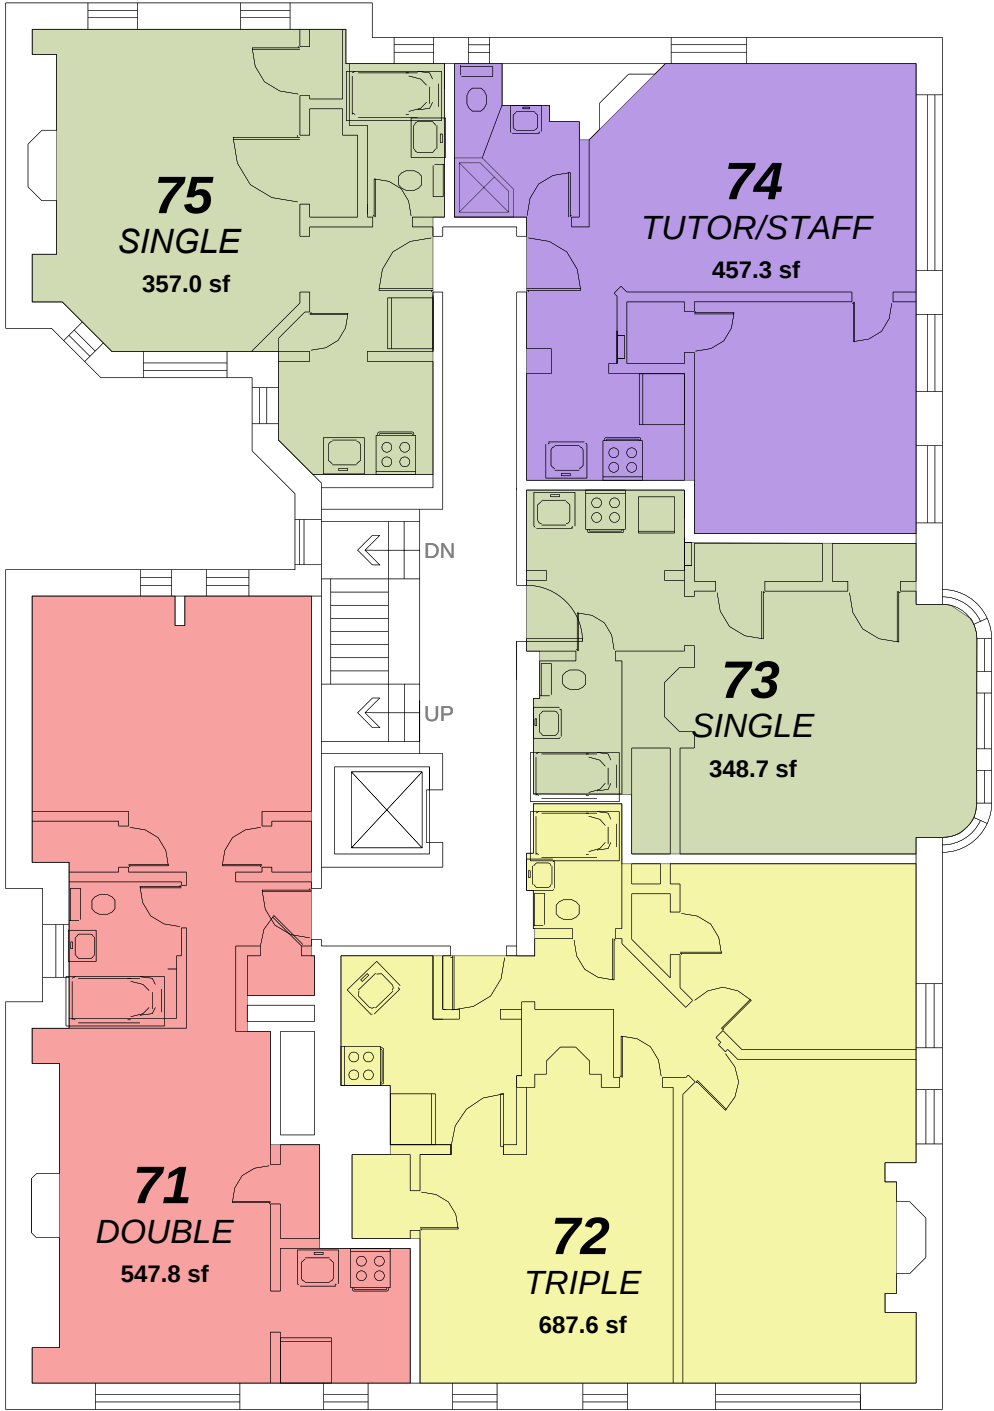



HARVARD UNIVERSITY

FACULTY OF ARTS AND SCIENCES

Office of Physical Resources and Planning

07

General (areas in SF)

|                                                                                                     | Units | Actual (SF) |
|-----------------------------------------------------------------------------------------------------|-------|-------------|
|  Res_1 Single    | 2.0   | 705.6       |
|  Res_2 Double    | 1.0   | 547.8       |
|  Res_3 Triple    | 1.0   | 687.6       |
|  Res_Tutor/Staff | 1.0   | 457.3       |
| TOTALS                                                                                              | 5.0   | 2,398.4     |

Ridgely Hall - Swing House

65 Mount Auburn Street Cambridge MA 02138

Seventh

As Built

Feb 11, 2022

1

2

4

8

16 feet

CenterStone



RIDGELY HALL

SEVENTH FLOOR

BLDG # 06098

DATE: 11/01/2012

